



MD 404 IS ASSUMED TO RUN IN AN EAST-WEST DIRECTION


SIGNS

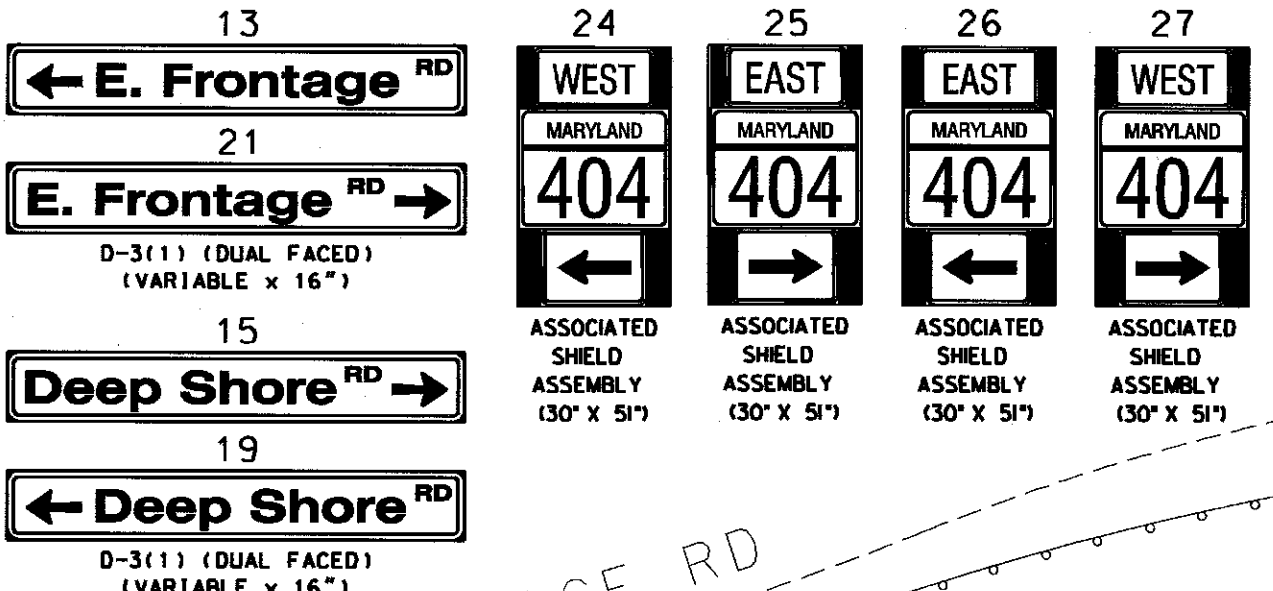


SIGNS

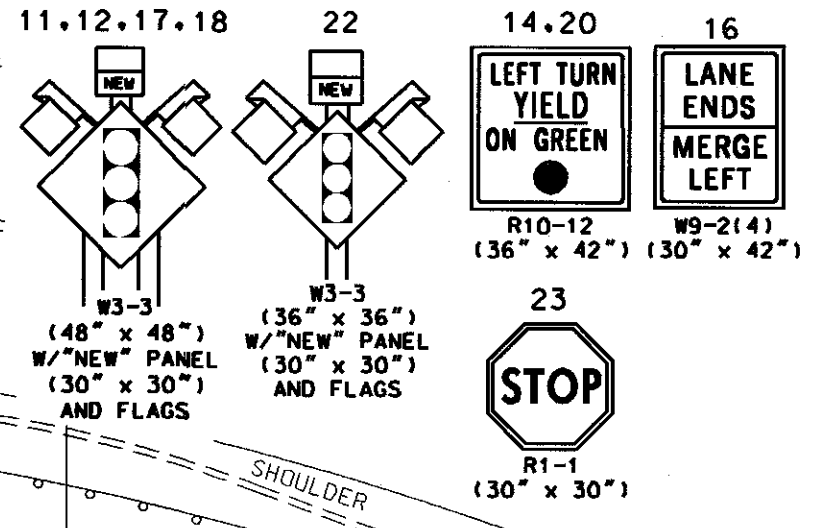

SIGNAL HEADS

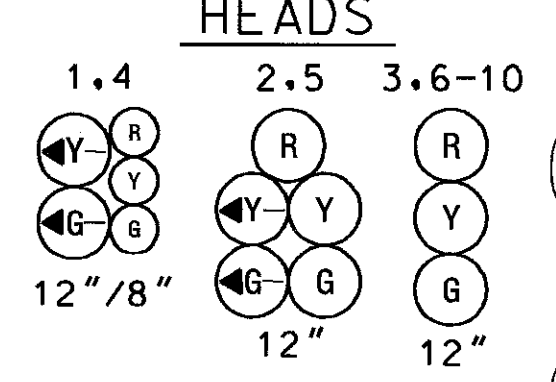

NEMA PHASING

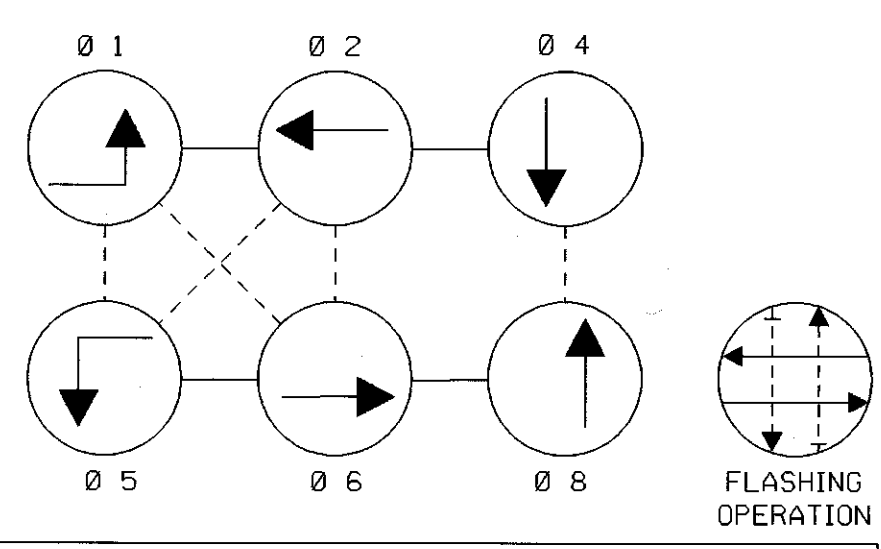

PHASING NOTES:
1. PHASES ASSOCIATED BY A SOLID LINE WILL NOT OPERATE CONCURRENTLY.
2. PHASES ASSOCIATED BY A DASHED LINE WILL OPERATE CONCURRENTLY.

CONSTRUCTION DETAILS

- A. INSTALL 27 FT. STEEL POLE WITH A TWIN 50 FT./60 FT. MAST ARMS, TRAFFIC SIGNAL HEADS, SIGNS AND 15 FT. STREET LIGHTING ARM WITH A 250 WATT HIGH PRESSURE SODIUM VAPOR LUMINAIRE. (INSTALL 1-2 IN. AND 1-4 IN. SCHEDULE 80, 90 DEGREE POLYVINYL CHLORIDE ELECTRICAL CONDUIT BENDS IN POLE BASE).
- B. INSTALL 27 FT. STEEL POLE WITH A TWIN 50 FT./60 FT. MAST ARMS, TRAFFIC SIGNAL HEADS, SIGNS AND 15 FT. STREET LIGHTING ARM WITH A 250 WATT HIGH PRESSURE SODIUM VAPOR LUMINAIRE. (INSTALL 1-2 IN. AND 1-4 IN. SCHEDULE 80, 90 DEGREE POLYVINYL CHLORIDE ELECTRICAL CONDUIT BENDS IN POLE BASE).
- C. INSTALL NEMA SIZE "6" BASE MOUNTED CABINET AND CONTROLLER WITH CONCRETE PAD. (INSTALL 2-2 IN. AND 2-4 IN. SCHEDULE 80, 90 DEGREE POLYVINYL CHLORIDE ELECTRICAL CONDUIT BENDS IN CABINET BASE.)
- D. INSTALL HANDHOLE.
- E. INSTALL 1 IN. LIQUID-TIGHT FLEXIBLE NON-METALLIC ELECTRICAL CONDUIT (DETECTOR WIRE SLEEVE).
- F. INSTALL 6 FT. x 30 FT. (3-6-3 WINDING) QUADRUPOLE TYPE LOOP DETECTOR ENCASED IN 1/4 IN. FLEXIBLE TUBING.
- G. INSTALL MICROLOOP PROBE SET WITH 1000 FT. LEAD-IN.
- H. INSTALL 2 IN. SCHEDULE 80, POLYVINYL CHLORIDE ELECTRICAL CONDUIT (BORED).
- J. INSTALL 3 IN. SCHEDULE 80, POLYVINYL CHLORIDE ELECTRICAL CONDUIT (TRENCHED).
- K. INSTALL 4 IN. SCHEDULE 80, POLYVINYL CHLORIDE ELECTRICAL CONDUIT (TRENCHED).
- L. INSTALL 4 IN. SCHEDULE 80, POLYVINYL CHLORIDE ELECTRICAL CONDUIT (BORED).
- M. INSTALL 24 IN. WHITE HEAT APPLIED PERMANENT PREFORMED THERMOPLASTIC PAVEMENT MARKING (STOP LINE).
- N. INSTALL W3-3 "SIGNAL AHEAD" SIGN (36 IN. x 36 IN.) WITH "NEW" PANEL AND FLAGS ON ONE 4 IN. x 4 IN. TREATED WOOD POST APPROXIMATELY 325 FT. IN ADVANCE OF THE INTERSECTION ON DEEP SHORE ROAD.
- O. INSTALL W3-3 "SIGNAL AHEAD" SIGN (48 IN. x 48 IN.) WITH "NEW" PANEL AND FLAGS ON TWO 4 IN. x 6 IN. TREATED WOOD POSTS APPROXIMATELY 625 FT. IN ADVANCE OF THE INTERSECTION ON EASTBOUND AND WESTBOUND MD 404.
- P. INSTALL 40 FT. LIGHTING STRUCTURE AND 20 FT. BRACKET ARM WITH A 250 WATT HIGH PRESSURE SODIUM VAPOR LUMINAIRE WITH PHOTOCCELL.
- Q. INSTALL 40 FT. LIGHTING STRUCTURE WITH BREAKAWAY BASE AND 10 FT. BRACKET ARM WITH A 250 WATT HIGH PRESSURE SODIUM VAPOR LUMINAIRE WITH PHOTOCCELL.
- R. INSTALL 2 IN. SCHEDULE 80, POLYVINYL CHLORIDE ELECTRICAL CONDUIT (TRENCHED) FOR PROPOSED UNDERGROUND ELECTRICAL SERVICE.
- S. INSTALL METERED SERVICE PEDESTAL WITH 200A, 2P MAIN CIRCUIT BREAKER WITH 1-60A 1P BRANCH CIRCUIT BREAKER FOR TRAFFIC SIGNAL AND 1-20A, 1P BRANCH CIRCUIT BREAKER FOR ROADWAY LIGHTING. INSTALL 2-2 IN. SCHEDULE 80, 90 DEGREE POLYVINYL CHLORIDE CONDUIT BENDS IN PEDESTAL BASE.
- T. INSTALL 4 IN. SCHEDULE 80, POLYVINYL CHLORIDE ELECTRICAL CONDUIT (TRENCHED) FOR PROPOSED UNDERGROUND ELECTRICAL SERVICE.
- U. INSTALL 4 IN. SCHEDULE 80, POLYVINYL CHLORIDE ELECTRICAL CONDUIT (BORED) FOR PROPOSED UNDERGROUND ELECTRICAL SERVICE.
- V. INSTALL 4 IN. SCHEDULE 80, POLYVINYL CHLORIDE ELECTRICAL CONDUIT (TRENCHED) FOR PROPOSED UNDERGROUND ELECTRICAL SERVICE. CAP AND MARK CONDUIT AT TRANSFORMER BASE FOR USE BY CHOPTANK ELECTRIC FORCES.
- W. INSTALL R1-1 SIGN (36 IN. x 36 IN.) ON ONE 4 IN. x 4 IN. TREATED WOOD SUPPORT.

GENERAL NOTES

- 1. ALL UNDERGROUND AND OVERHEAD UTILITIES SHOWN ON THESE PLANS ARE SCHEMATIC ONLY AND MAY NOT BE COMPLETE. THE CONTRACTOR SHALL BE RESPONSIBLE FOR NOTIFYING MISS UTILITY PRIOR TO THE CONSTRUCTION SO THAT ALL UTILITIES MAY BE LOCATED IN THE FIELD. IF THE CONTRACTOR PERCEIVES THAT A CONFLICT BETWEEN UTILITIES AND THE TRAFFIC SIGNAL WILL OCCUR, THE CONTRACTOR SHALL NOTIFY THE PROJECT ENGINEER IMMEDIATELY SO THAT THE CONFLICT MAY BE RESOLVED.
- 2. INSTALL CONDUIT AND LOOP DETECTORS PRIOR TO THE INSTALLATION OF PAVEMENT MARKINGS. REFER TO SIGNING AND PAVEMENT MARKING PLANS FOR ADDITIONAL DETAILS.
- 3. VERIFY PROPOSED GEOMETRICS PRIOR TO INSTALLING SIGNAL EQUIPMENT.
- 4. ALL HANDHOLES SHALL BE INSTALLED AT FINAL GRADE.

LEGEND OF UNDERGROUND AND OVERHEAD UTILITIES	
AERIAL CABLE	A
ELECTRICAL	E
TELEPHONE	T
GAS	G
SEWER	SS
STORM DRAIN	SD
WATER	W
CABLE TV	TV

REVISIONS		APPROVALS	
1	ADDED LOOP DETECTORS	TEAM LEADER	TRAFFIC ENGINEERING DESIGN DIVISION
2	REDLINE REVISION NO. 1	ASST. TRAFFIC ENGINEERING DESIGN DIVISION	
3		CHECK TRAFFIC ENGINEERING DESIGN DIVISION	
4		DIRECTOR, TRAFFIC & SAFETY	

WR&A
Whitman, Reardon
and Associates, LLP
801 South Caroline Street
Baltimore, Maryland 21231
(410) 235-3450

MARYLAND DOT - STATE HIGHWAY ADMINISTRATION
Office of Traffic & Safety
TRAFFIC ENGINEERING DESIGN DIVISION
TRAFFIC SIGNALIZATION PLAN
MD 404 AND DEEP SHORE ROAD

DRAWN BY: S. BLOSS	F.A.P. NO. C03215170	SEE TITLE SHEET	TS NO. TS-3208
CHECKED BY: N. LEARY	S.H.A. NO. CAROLINE	LOG MILE: 05040909.94	T.I.M.S. NO.
SCALE: 1" = 20'	COUNTY: CAROLINE		
DATE: 2/10/2003			

SHEET NO. 64 OF 76